




**SITE KEYNOTES:**

	DETAIL - SHEET	DETAILED PRODUCT INFORMATION
<b>1.0 SITE FURNITURE</b>		
1.1 Salvaged Boulder	Average 600-900mm	Roughly 80-90
1.2 Weir	1/ L4.05	Quantity: 7
<b>2.0 PLANTING AND LANDSCAPE</b>		
2.1 Shrub and Tree Planting Area - 594 Sq.M	Watercourse cut and fill slopes	2P growing medium, 300 mm depth
2.2 Hydroseed - 872 Sq.M		Vancouver Island/Coast Mix per MOTI specifications

**PLANT LIST**

Sym	Qty	Botanical Name	Common Name	Schd. Size / Plant Spacing
<b>TREES:</b>				
T1	12	Pseudotsuga menziesii	Douglas Fir	#15 pot
<b>SHRUBS/FERNS/GRASSES/VINES:</b>				
Csc-2	183	Cornus sericea	Red-twig Dogwood	Whip 0.9 MoC
Hd	41	Hedysar discolor	Oceanspray	#1 pot 1.2 MoC
Rn	158	Rosa nutkana	Nootka Rose	#1 pot 0.75 MoC
Ssw	183	Salix scouleriana	Scouler's Willow	Whip 0.9 MoC
Sa	264	Symphoricarpos alba	Snowberry	#1 pot 0.75 MoC

- NOTES**
- Tree pits to be excavated per Town of View Royal DWG No. VRSD-L2 on DWG No. TP1-L4.01
  - Tree pits to be:
    - Marked with 2"x4" stake at centre of pit, firmly driven into existing ground with minimum 2 feet of stake above finished ground.
    - Surveyed with coordinates provided to the engineer.
    - Backfilled with approved growing medium flush to surrounding backfill.

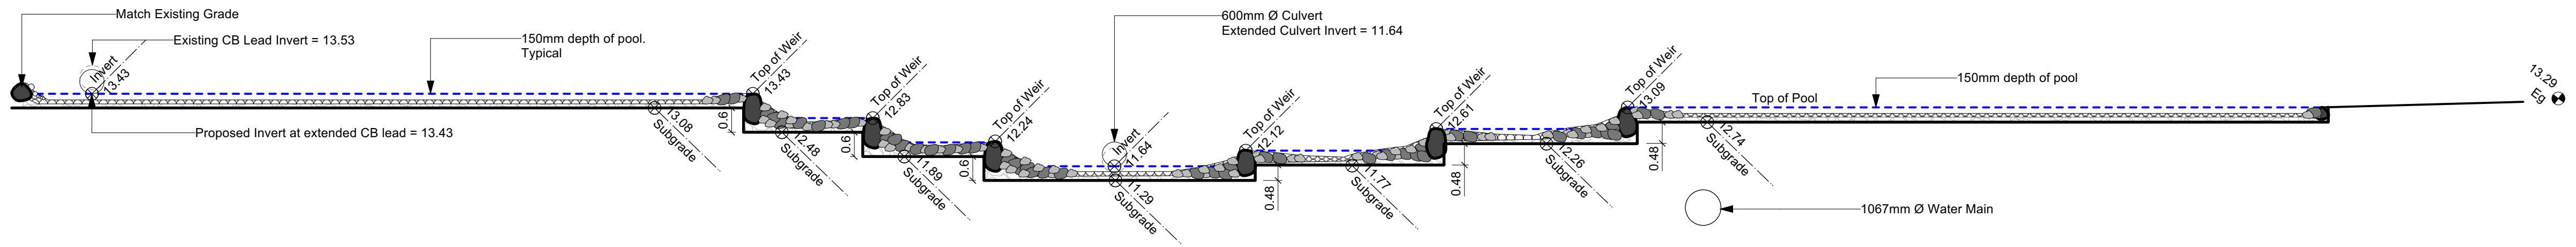

1 Proposed Ditch Profile  
Scale: 1:100



Suite 310, 4321 Still Creek Drive  
Burnaby, British Columbia, V5C 6S7  
Tel: 604 454 0402 Fax: 604 454 0403  
www.morrisonhershfield.com

**D'AMBROSIO**  
architecture + urbanism



All dimensions in Metric

REV	DESCRIPTION	DATE
A	CCO-028	2022-06-22

DO NOT SCALE FROM DRAWINGS. CONTRACTOR MUST VERIFY ALL DIMENSIONS ON SITE AND ADVISE CONSULTANTS OF ANY ERRORS OR OMISSIONS. NO VARIATIONS OR MODIFICATIONS TO WORK SHOWN SHALL BE IMPLEMENTED WITHOUT PRIOR WRITTEN APPROVAL. ALL PREVIOUS ISSUES OF THIS DRAWING ARE SUPERSEDED BY THE LATEST REVISION. ALL DRAWINGS AND SPECIFICATIONS REMAIN THE PROPERTY OF MORRISON HERSHFIELD.

STAMPS



CLIENT: BC TRANSIT  
PROJECT: VICTORIA handyDART TRANSIT CENTRE  
**Landscape Materials**

SCALE: 1:200	PROJECT NO. 201919500
DWG.# TP1-L-1.02	REV DATE: